



PŘÍLOHA č.6

PLÁNEK PŮDORYSU SKLEPENÍ

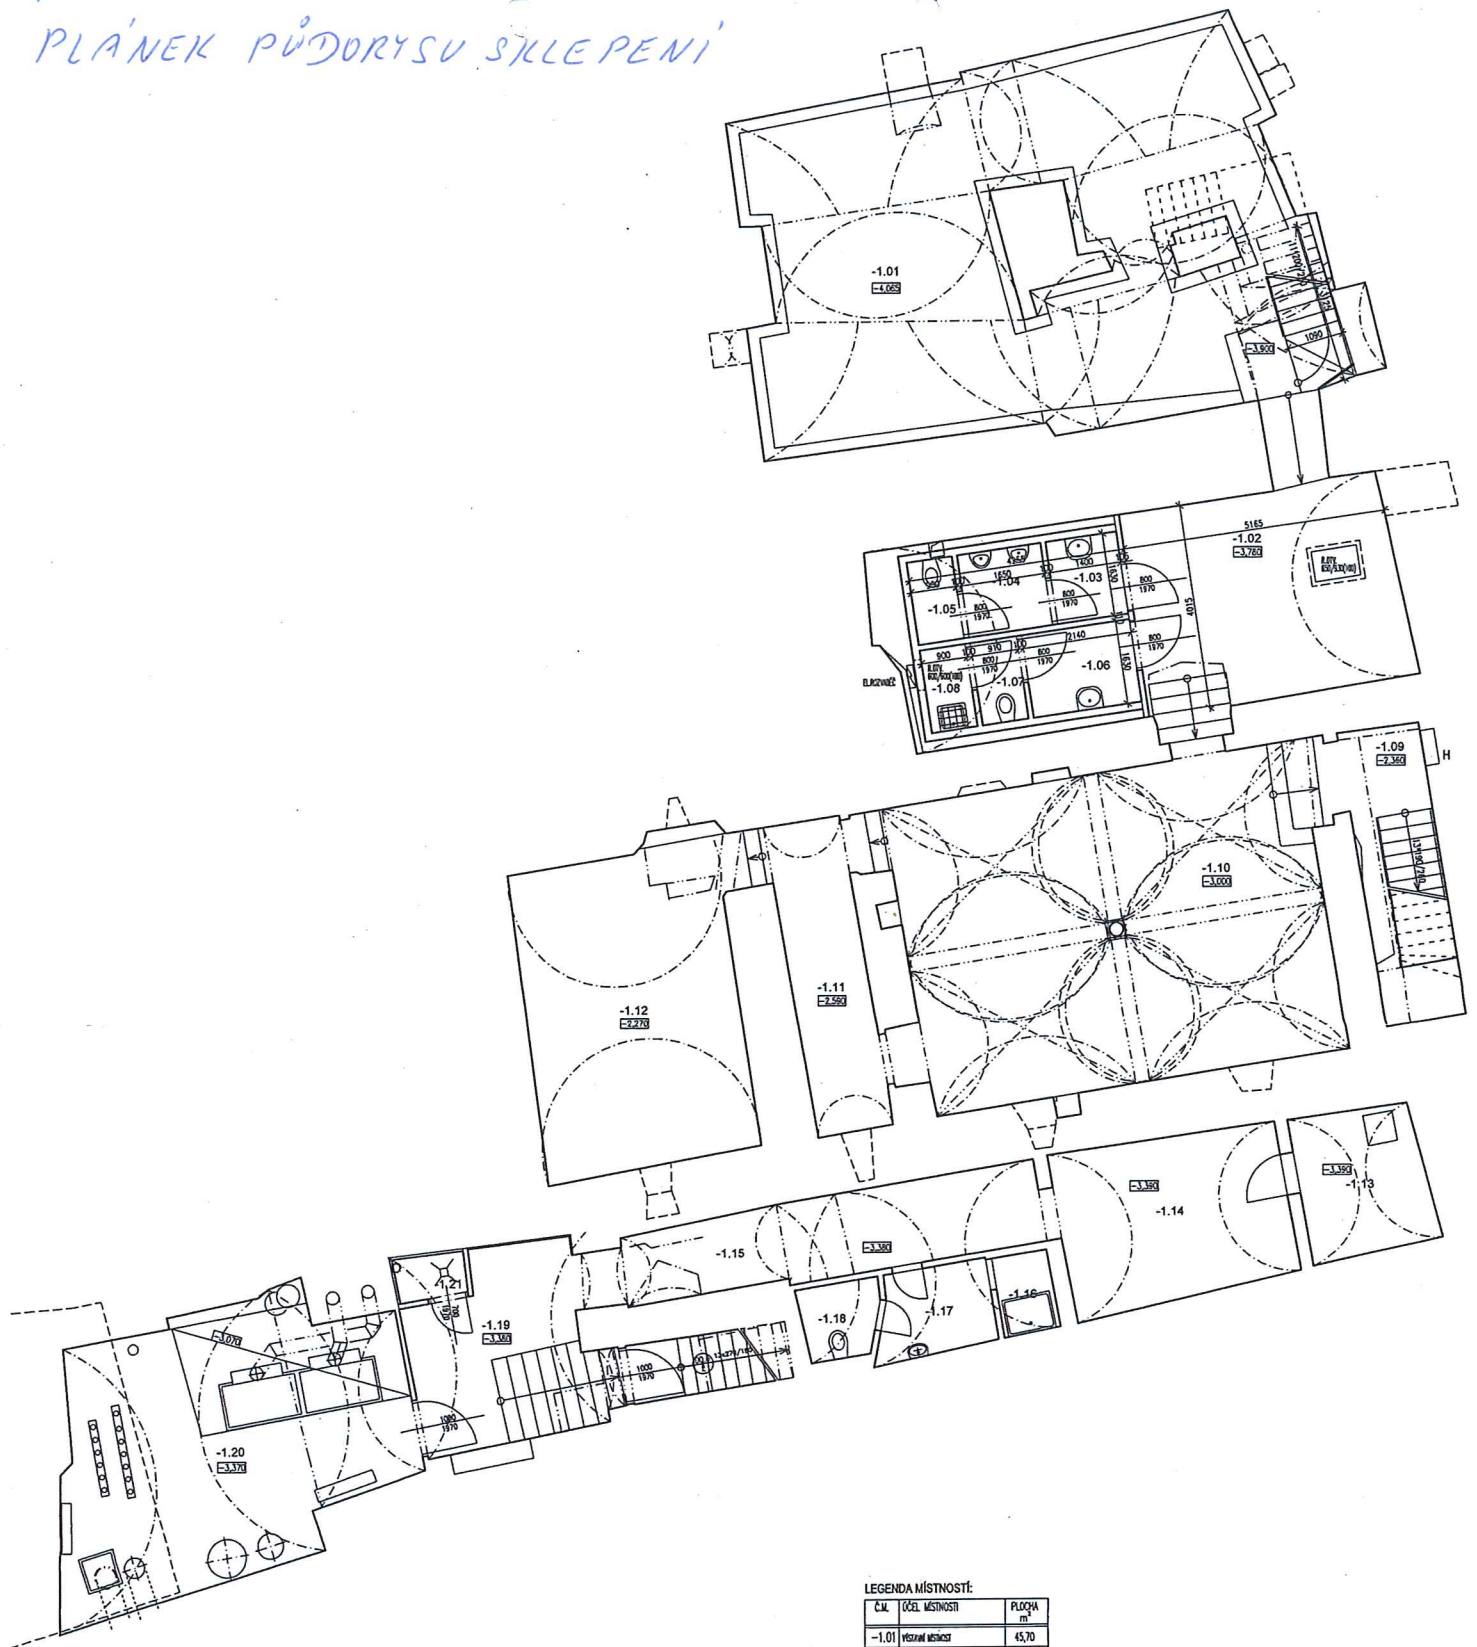

LEGENDA MÍSTNOSTÍ:

Č.č.	ÚČEL MÍSTNOSTI	PLOCHA m ²
-1.01	VÝSTAVNÍ MÍSTNOST	45,70
-1.02	KUCHY - PŘEDSÍ	24,93
-1.03	KC MŮB - JEDNODNĚ PŘEDSÍ	2,08
-1.04	KC MŮB - PŘEDSÍ	2,47
-1.05	KC MŮB - KUCHY	1,35
-1.06	KC ŽENY - PŘEDSÍ	3,07
-1.07	KC ŽENY - KUCHY	1,50
-1.08	KLADNÁ KUCHY	1,35
-1.09	KUCHY SE SCHODIS	8,61
-1.10	VÝSTAVNÍ MÍSTNOST	45,17
-1.11	SKL	3,60
-1.12	SKL	22,68
-1.13	TECHNICKÁ MÍSTNOST	6,84
-1.14	TECHNICKÁ MÍSTNOST	14,15
-1.15	KUCHY	13,53
-1.16	KC	1,70
-1.17	INŽENÝR	3,68
-1.18	SPRKA	2,14
-1.19	KUCHY	13,64
-1.20	KUCHY	33,29
-1.21	KUCHY SKL	1,2

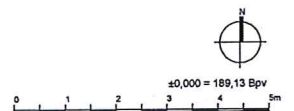


STAVBY REKONSTRUKCE HISTORICKÉHO OBJEKTU SE SMÍŠENÝM FUNKČNÍM MÍSTNOSTI: LA Mladá, čp. 18229, 21/155 par. 8/114, 115, Praha 1, kst. úz. 727/024 Staré Město			
INVESTOR	PROJEKTANT	OPR. PROJEKTANT	OPR.
Stavba státního archivu (SASQ)	STANISLAV SLANEČEK	Ing. arch. Pavel Píbl	Ing. arch. Pavel Píbl
Stavba státního archivu (SASQ)	STANISLAV SLANEČEK	Ing. arch. Pavel Píbl	Ing. arch. Pavel Píbl
ZPRACOVATEL ČÁSTI PROJEKTU:			
STANISLAV SLANEČEK	STANISLAV SLANEČEK	STANISLAV SLANEČEK	STANISLAV SLANEČEK
DOKUMENTACE SKUTEČNÉHO PROVEDENÍ			
A	PODROBNÁ STAVBA A KONSTRUKCE	OPR.	31.1.2012
A.1	ARCHITEKTONICKO A STAVBYNĚ TECHNICKÉ ŘEŠENÍ	OPR.	31.1.2012
A.1.2	VÝKRESOVÁ DOKUMENTACE	OPR.	31.1.2012
A.1.2.1	PŮDORYS	OPR.	31.1.2012
A.1.2.2	SKL	OPR.	31.1.2012
A.1.2.3	PŮDORYS 1.PP	OPR.	31.1.2012

Architectural floor plan of a building with multiple rooms and a central hall. Rooms are labeled with numbers and elevations: -1.01, -1.02, -1.03, -1.04, -1.05, -1.06, -1.07, -1.08, -1.09, -1.10, -1.11, -1.12, -1.13, -1.14, -1.15, -1.16, -1.17, -1.18. The plan includes a central hall with a staircase, several rooms with furniture, and a large room with a circular pattern. The plan is oriented with a north arrow pointing towards the top right.

LEGENDA MÍSTNOSTÍ:

C.M.	OCEL MÍSTNOSTI	PLOCHA m²
-1.01	Vestibul místnost	45,70

Čís.	ÚČEL VEŠTINOSTI	POLOHA m ²
-1.01	PRÁVNÍ VEŠTINOST	45,70
-1.02	PRÁVNÍ - PRÁVNÍ	24,93
-1.03	VE ŠKOLY - ZÁKONNOST PRÁVNÍ	2,09
-1.04	VE ŠKOLY - PRÁVNÍ	2,47
-1.05	VE ŠKOLY - PRÁVNÍ	1,35
-1.06	VE ŠKOLY - PRÁVNÍ	3,07
-1.07	VE ŠKOLY - PRÁVNÍ	1,35
-1.08	PRÁVNÍ PRÁVNÍ	1,50
-1.09	PRÁVNÍ PRÁVNÍ	9,81
-1.10	PRÁVNÍ VEŠTINOST	45,17
-1.11	PRÁVNÍ	3,60
-1.12	PRÁVNÍ	22,68
-1.13	PRÁVNÍ VEŠTINOST	6,94
-1.14	PRÁVNÍ VEŠTINOST	14,15
-1.15	PRÁVNÍ	1,53
-1.16	PRÁVNÍ	1,70
-1.17	PRÁVNÍ	3,66
-1.18	PRÁVNÍ	2,14
-1.19	PRÁVNÍ	13,64
-1.20	PRÁVNÍ	13,29
-1.21	PRÁVNÍ PRÁVNÍ	3,29

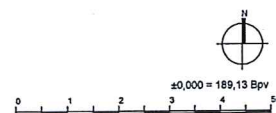[illegible]